



NOTE: ALL WALLS ARE DIMENSIONED FROM FINISH FACE OF WALL UNLESS NOTED OTHERWISE
DIMENSIONS ARE TO AN AVERAGE DIMENSION ALONG FACE OF WALL

- ROOM LEGEND**
- OPEN SPACE
- DOOR LEGEND**
- EXISTING DOOR
- WALL LEGEND**
- EXISTING STUD WALLS
 - ELEMENTS ABOVE

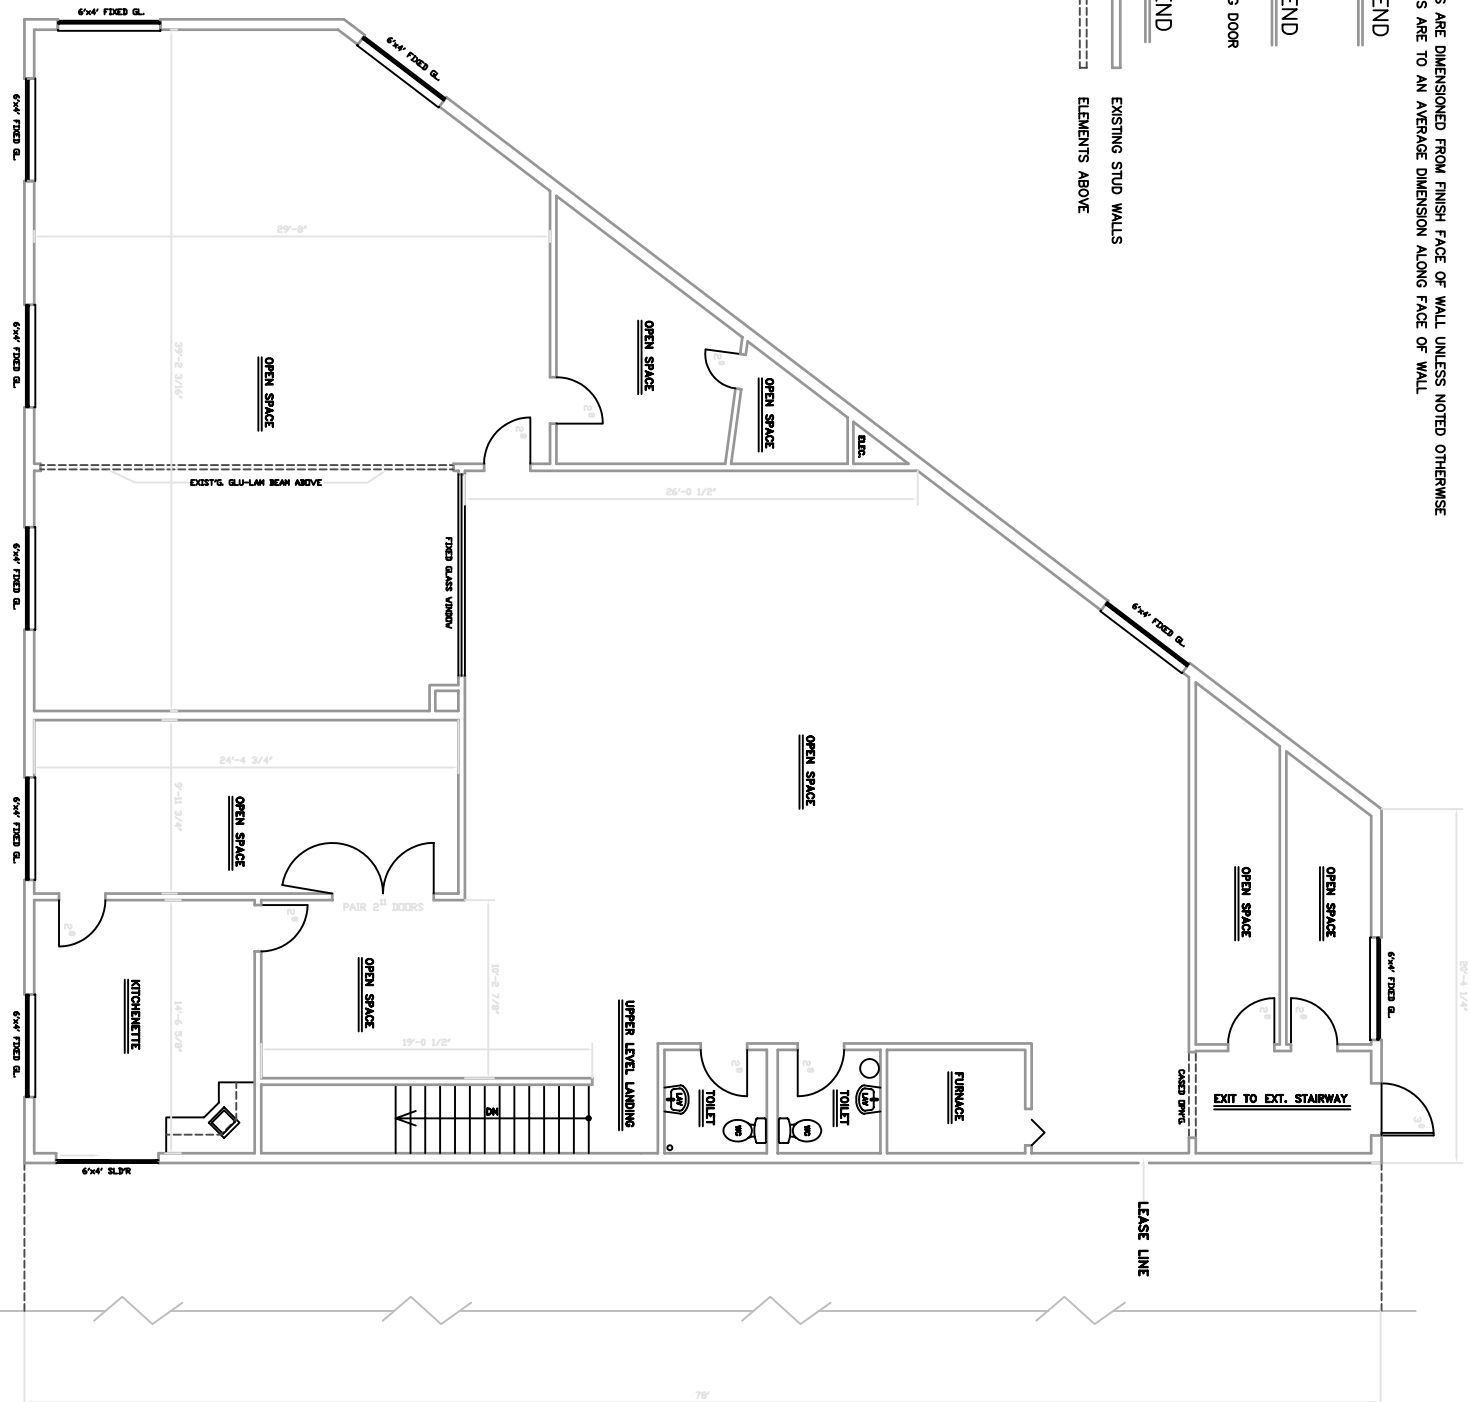


UPPER FLOOR LEASE AREA
3,779 SQ. FEET
MEASUREMENTS TAKEN FROM EXTERIOR FACE OF EXTERIOR WALLS & CENTER OF INTERIOR WALLS SEPARATING ADJOINING LEASE SPACES WHERE SUCH CONDITIONS EXIST.

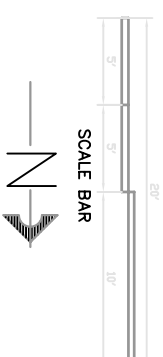

” AS-BUILT ” UPPER LEVEL FLOOR PLAN


Scale: 1/4" = 1'-0"

” AS-BUILT ” LOWER LEVEL FLOOR PLAN

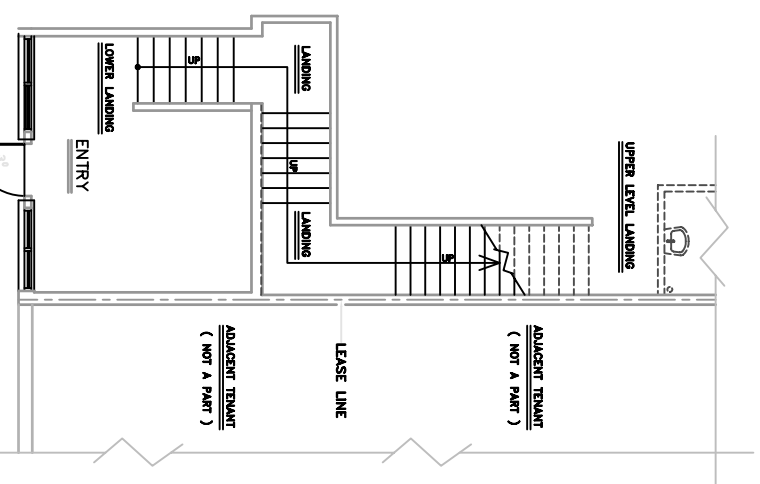

PUYALLUP RETAIL OR OFFICE SPACE
12704 MERIDIAN AVENUE EAST

No.	Revision Description	Approved By	Date
1	2082		

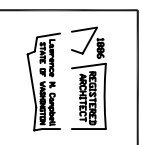

Sheet Number
A-3.2
of

7/26/2010